


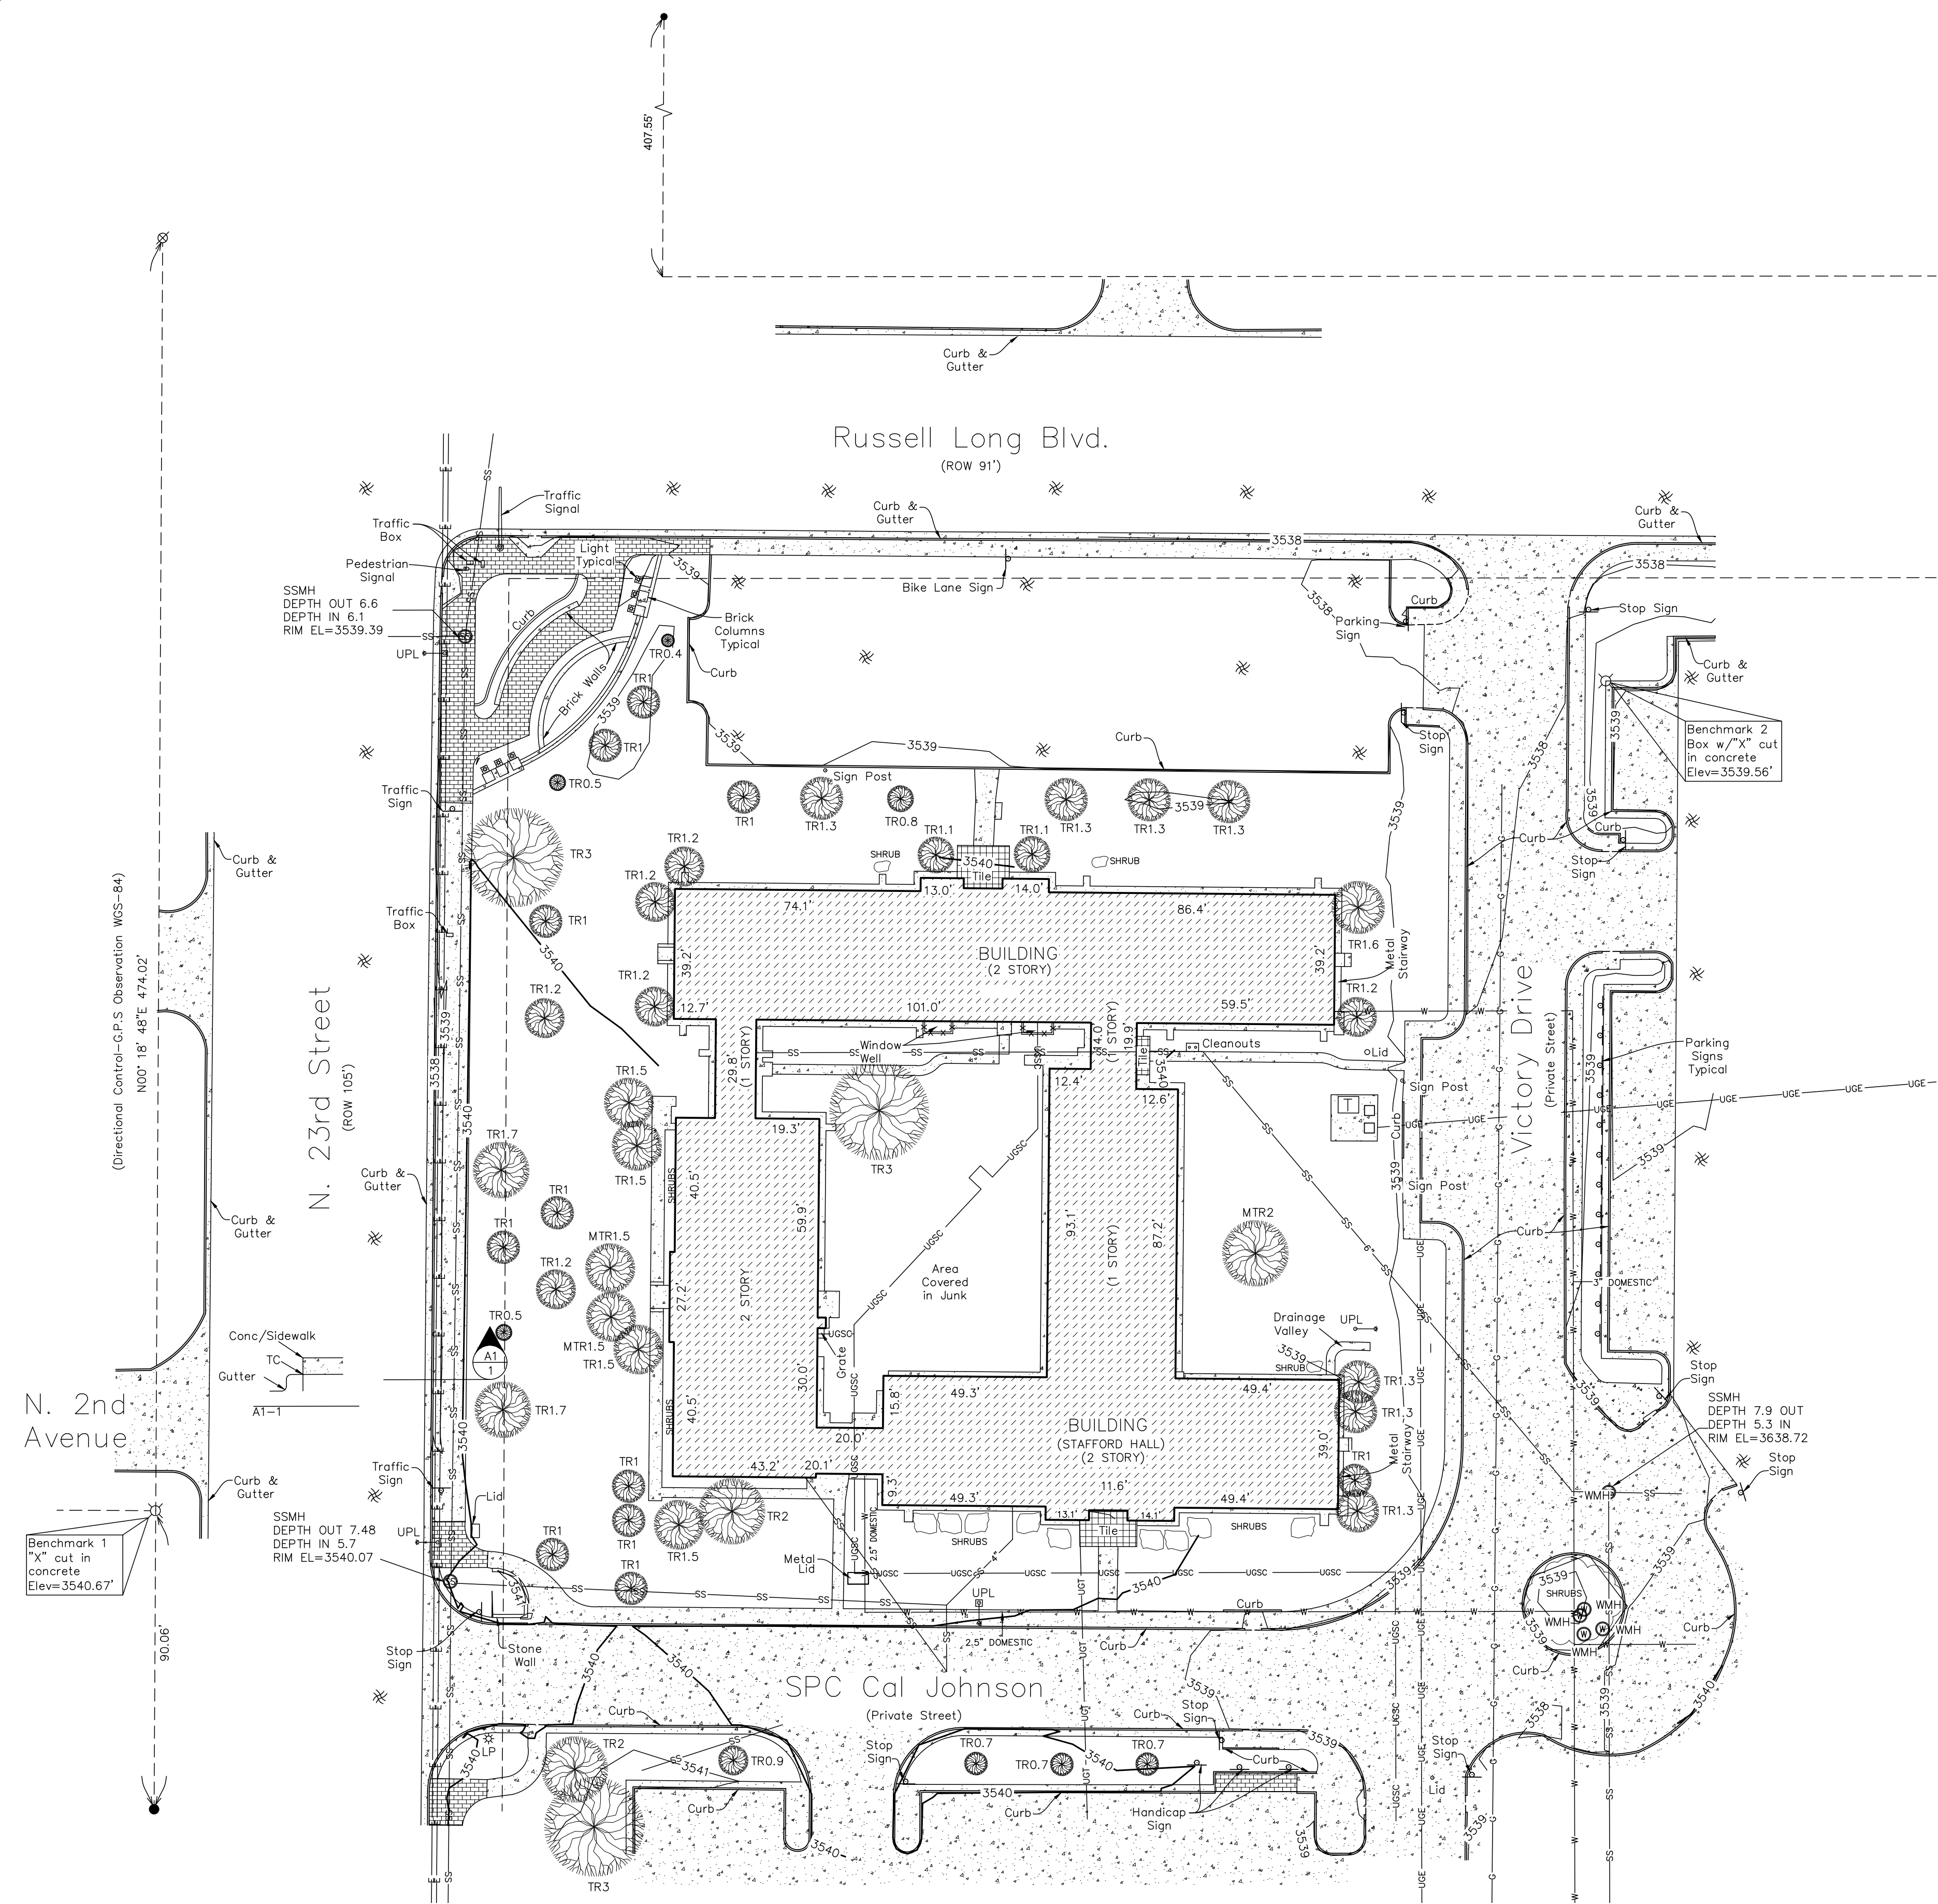

Notes:

- 1.) Down spouts, roof drains, sprinkler systems, area lights, conduits, metal stairways and electric boxes attached to building and parking stripes are not shown on this survey.
- 2.) Underground utility information shown were scaled from copies of utility drawing provided by West Texas A & M University in 2004 and from main campus utilities CAD drawing dated 052915 and 082917.

3.)Elevation Datum per PBSJ Topographic Survey Dated March 4, 2002. Datum conversion to NAVD88 add 1.91 feet to all elevations.

Legend :

- =1/2" iron rebar (found)
- =3/8" iron rebar (found)
- ⊗ = "X" cut in concrete (found)
- △ E T W G =utility meter and/or box
- E- =overhead utility lines
- ▨ =concrete area
- ※ =asphalt area
- X- =fence
- UP-XTGLC =utility pole w/light, cross arm, transformer, conduit &/or guy
- SSMH =sanitary sewer manhole
- WMH =water manhole
- (/) =Instrument recording in County Clerks Office
- TR1.6 =tree w/trunk diameter in feet
- MTR =multi trunk tree


Utility notes

- W---underground water line
- SS---underground sanitary sewer line
City of Canyon or West Texas A&M University
- SD---underground storm sewer line
City of Canyon or West Texas A&M University
- G---underground natural gas line
Atmos, Engineering Department
306 N. Grand Street, Amarillo, Texas
John Cain (806)220-6639
or West Texas A&M University
- E----overhead electric line
- UGE--underground electric line
Xcel Energy, Engineering Dept.
P.O. Box 1261 - 11th Floor, Amarillo, Texas 79170
Al Hutchings (806) 378-2303
or West Texas A&M University
- T----overhead telephone line
- UGT--underground telephone line
Southwestern Bell Telephone Company
(800) 464-7928
- TV---overhead cable TV line
- UGTV-underground cable TV line
Suddenlink
5800 W. 45th Avenue, Amarillo, Texas 79109
(806) 358-4801
- UGSC--- underground steam and condensation line
West Texas A&M University
- UGFWL---underground fire water line
West Texas A&M University

Underground utility lines were not uncovered and located. Utility information shown hereon is determined by the utility's surface features located by this survey and/or by the utility company's records. Field verify, check with utility companies and check area closely prior to any excavation or construction in areas shown on this plat.




Dial 811 before you dig
The utilities as shown on this drawing were developed from the information available, this is not implied nor intended to be the complete inventory of utilities in this area. It is the clients responsibility to verify the location of all utilities (whether shown or not) and protect said utilities from any damage.

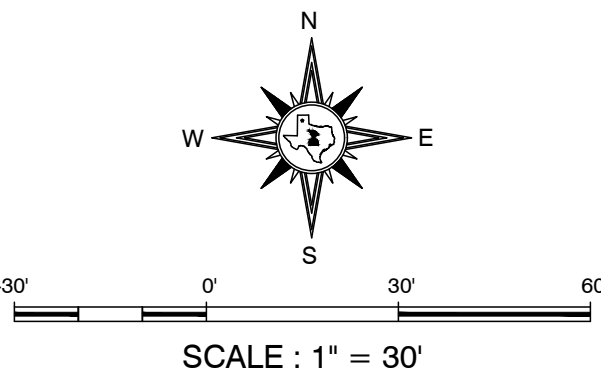

Topographic Survey of
WTA&M University
Stafford Hall
Canyon, Randall County, Texas

Robert Keys & Associates

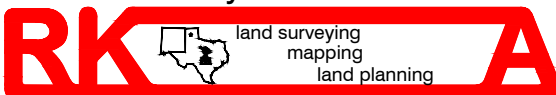

Survey Date: 06/28/2004
06/29/2004
07/02/2004
07/06/2004
09/03/2019
09/10/2019

(806)352-1782 Email: rka@keysurveying.com
7106 S. Bell Street, Amarillo, Texas 79109-7003
Firm No. 10034400 www.keysurveying.com